

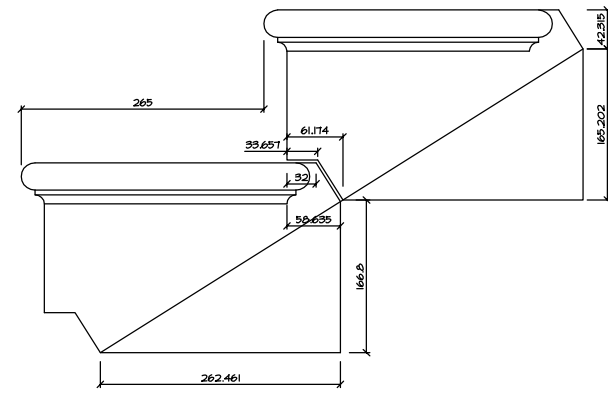



Ground Floor

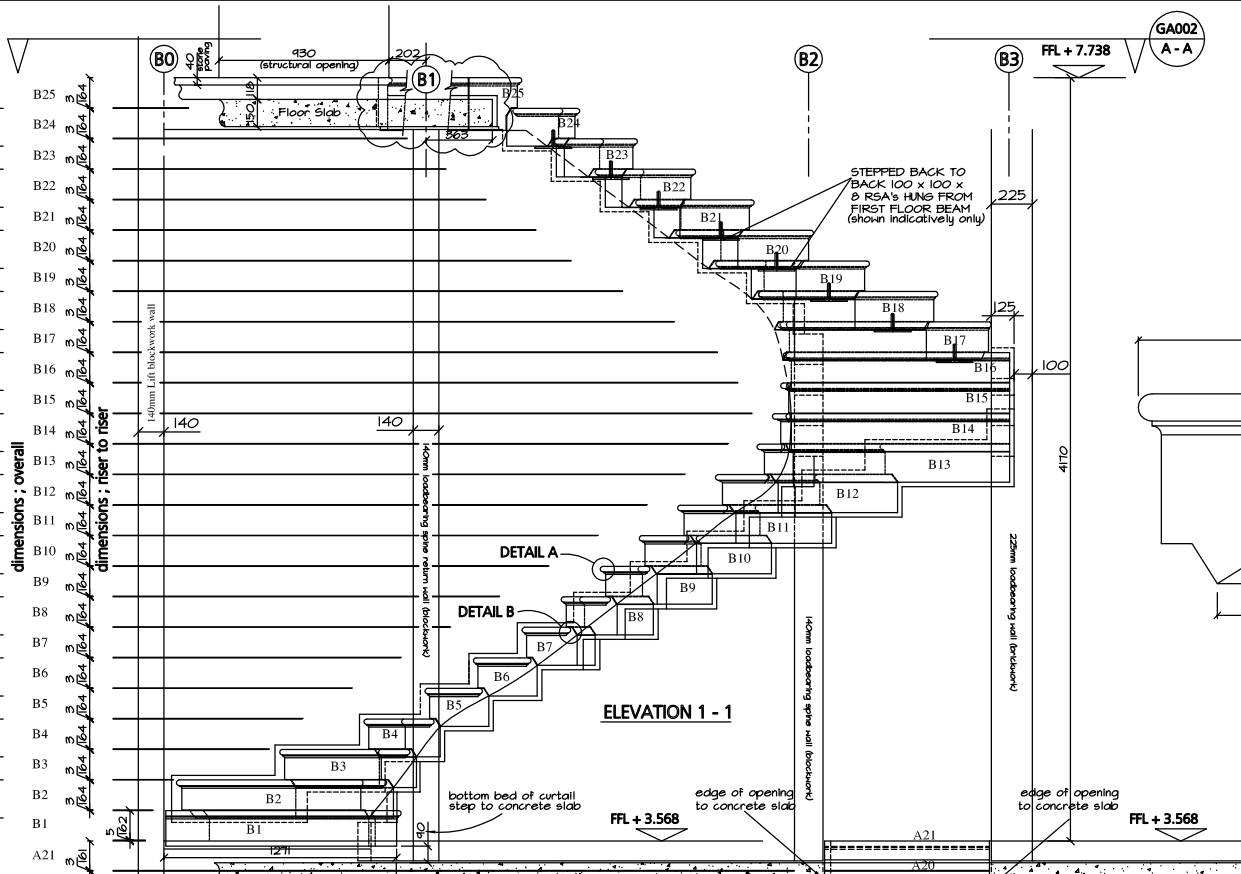


Side Elevation @ 1:2

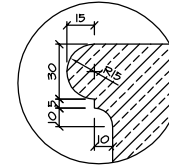

SIDE ELEVATION DETAIL A @ 1:1

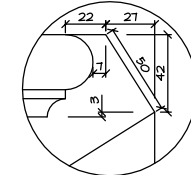

SIDE ELEVATION DETAIL B @ 1:1

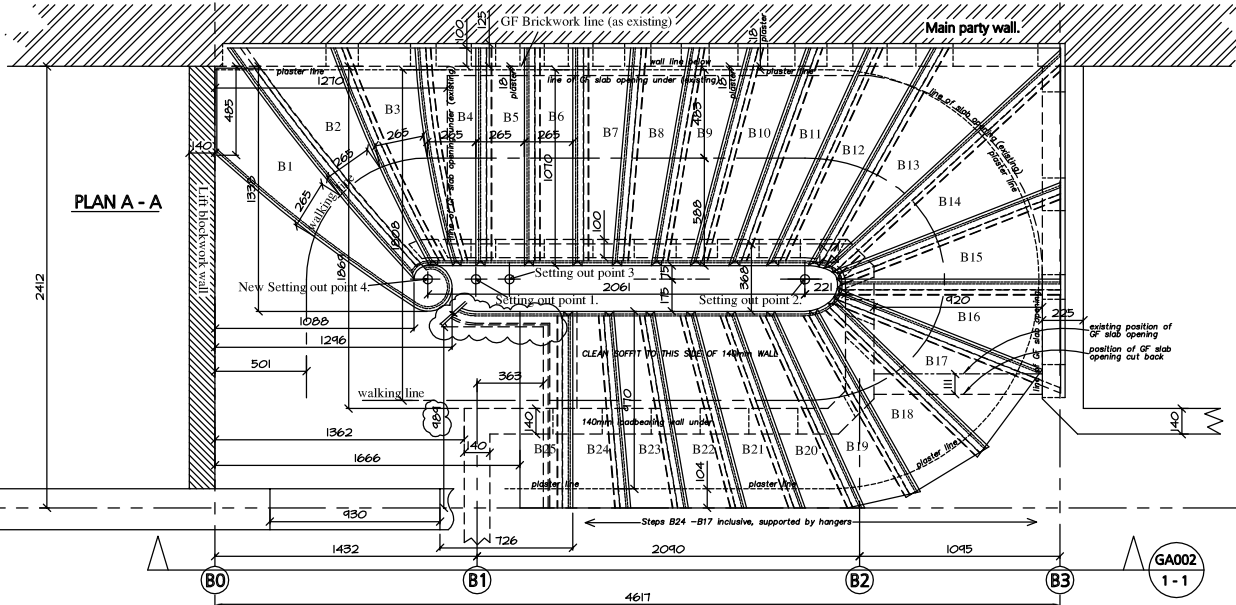

PLAN A - A

KEY PLAN		
<p>NOTE: ALL FIXINGS TO BE STAINLESS STEEL UNLESS STATED OTHERWISE. DWGS TO BE READ IN CONJUNCTION WITH ARCHITECTS DWGS</p> <p>All stone beds and joints to be 3mm except where stated.</p> <p>All dimensions/details clouded as such to be confirmed.</p> <p>Dimension styles: </p> <p>Stone type: PORTLAND This drawing to be read in conjunction with drawing nos: BW003</p>		
DRAWING CREATED BY		
<p>stewart design (uk) limited Tel: +44 (0) 1865 811500 Fax: +44 (0) 1865 811700 e-mail: design@stewartdesign.co.uk website: www.stewartdesign.co.uk</p>		
REV	DATE	AMENDMENT
A	26.06.00	Bottom step added back in, 2 No Steps added at lower level Upper level steps adjusted Setting out points updated
B	06.07.00	Curtail step scroll amended, curved wall at half way point omitted and trellis extended.
C	26.07.00	New slab positions updated, Stone facing to slab at wall end added - (first floor)
Issued for		
<input type="checkbox"/> As Built <input type="checkbox"/> Information <input type="checkbox"/> Site		
COPYRIGHT Not to be reproduced without written permission		
PROJECT 41 Upper Brook Street Mayfair London		
DRAWING TITLE STONEMASONRY New stair layout Ground Floor Level Stone stair details.		
AXTELL PERRY SYMM MASONRY LIMITED OSNEY MEAD, OXFORD, OX2 0BQ TEL: (01865) 254600 FAX: (01865) 254617 E-mail: Dene@APSMasonry.com		
DRAWN BY	JPS	Checked by: AGM
SCALE	1:10 @ A0	
DATE	5th June 2000	
DRAWING No.	OX36	DWG No. GA002
		REV C