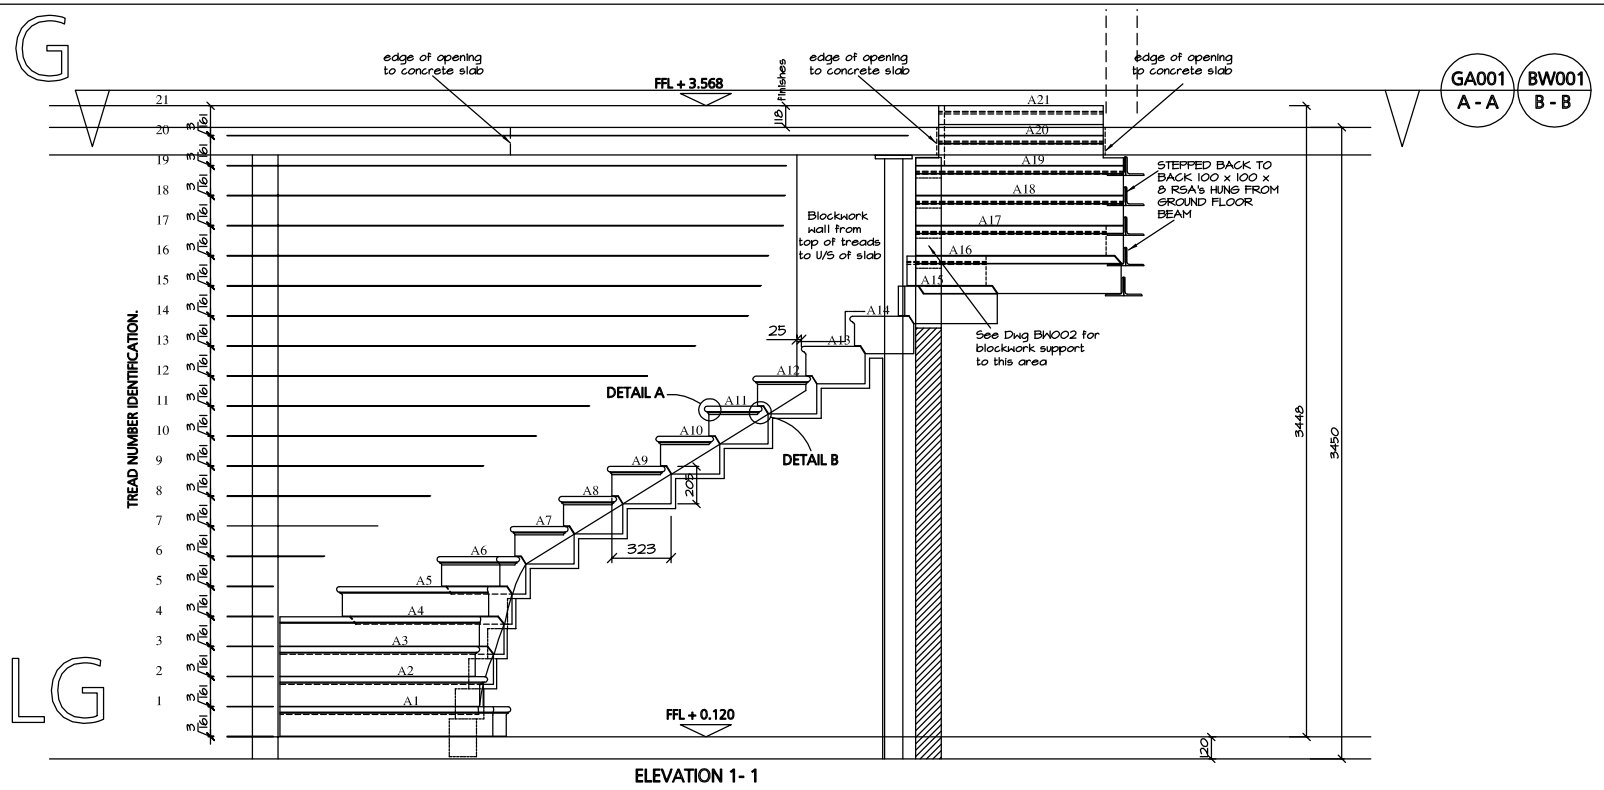

ELEVATION 1- 1

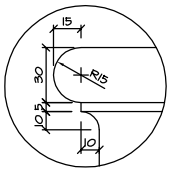

SIDE ELEVATION DETAIL A

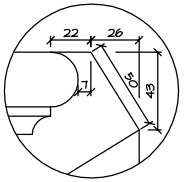

SIDE ELEVATION DETAIL B

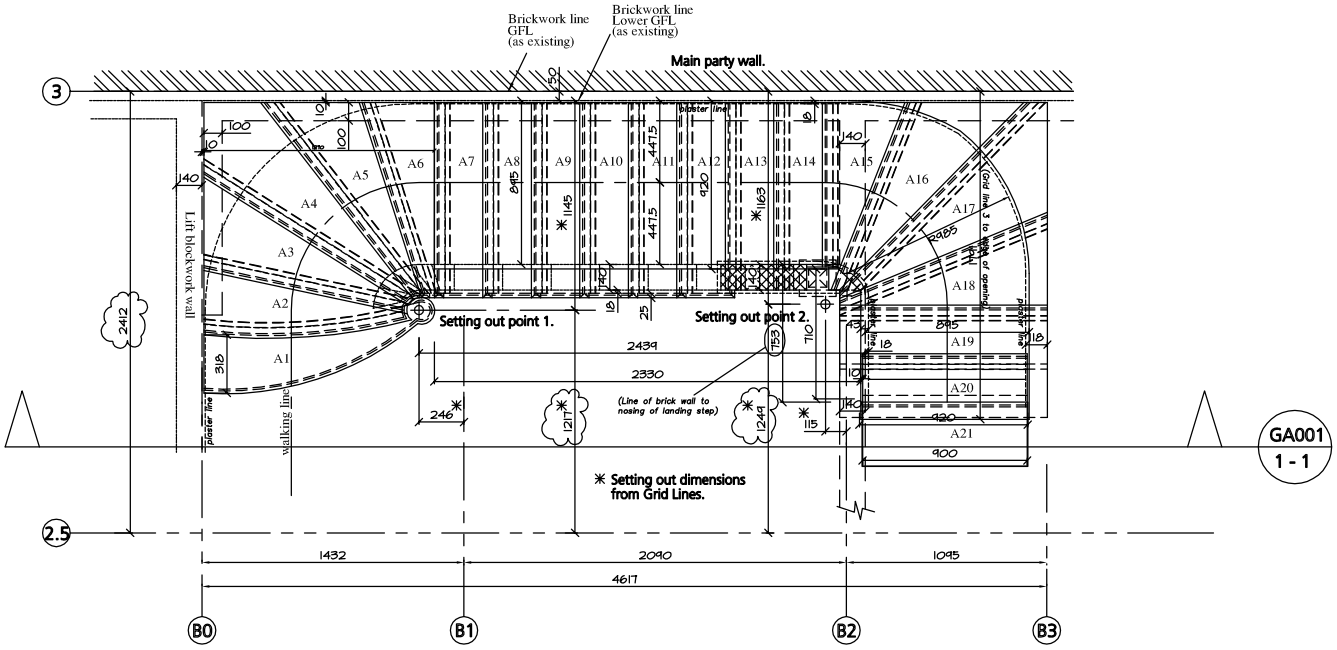

✳ Setting out dimensions from Grid Lines.

PLAN VIEW A - A

KEY PLAN

NOTE:
ALL FIXINGS TO BE STAINLESS STEEL UNLESS STATED OTHERWISE
DWG'S TO BE READ IN CONJUNCTION WITH ARCHITECTS DWG'S

DRAWING CREATED BY

stewart design (uk) limited
Tel: + 44 (0) 1608 811500 Fax: + 44 (0) 1608 811700
e-mail: design@stewartdesign.co.uk
website: www.stewartdesign.co.uk

REV	DATE	AMENDMENT
B	6.6.00	Design team comments incorporated-radial blockwork wall on Grid Line B0 amended
A	31.5.00	Design team comments incorporated. General update.

Issued for
- ☐ As Built
- ☒ Information
- ☐ Site

COPYRIGHT
Not to be reproduced without written permission

PROJECT
41 Upper Brook Street
Mayfair
London

DRAWING TITLE
STONEMASONRY
New stair layout
Lower Ground Floor Level
Stone stair details.

APS Masonry
AXTELL PERRY SYMM MASONRY LIMITED
OSNEY MEAD, OXFORD, OX2 0EQ
TEL: (01865) 254600
FAX (01865) 254617
E-mail Dean@APSMasonry.com

DRAWN BY	JPS	Checked by	AGM
SCALE	1:10 @ A0		
DATE	15th May 2000		
DRAWING No.	JOB No XO36	DWG No GA001	REV B